

## View and Print Side Sewer Inspection Cards

The City of Tacoma has permit records for some, but not all, of the side sewer inspections in the City of Tacoma. The following steps will guide you through viewing side sewer inspection cards, if any exist for a property. If you have difficulties following the steps below or are unable to find inspection cards, contact Environmental Services at (253) 591-5588 for further help.

**Step 1** – Visit [cityoftacoma.org](http://cityoftacoma.org).

**Step 2** – At the top of the page, under **What is the address? -**

A. Enter your house number

Some addresses will appear

If you don't see your address, enter the direction or part of the street name.

For example: For 324 E D ST, enter "324 E"

For 747 Market ST, enter "747 M"

You may need to try different combinations until you see your address.

B. Select your address and



C. Click on the magnifying glass to submit.

**Step 3** – Under **Inspection Cards** and **Filenames**, Inspection Cards (if there are any) will appear as 8-digit alpha-numeric links.


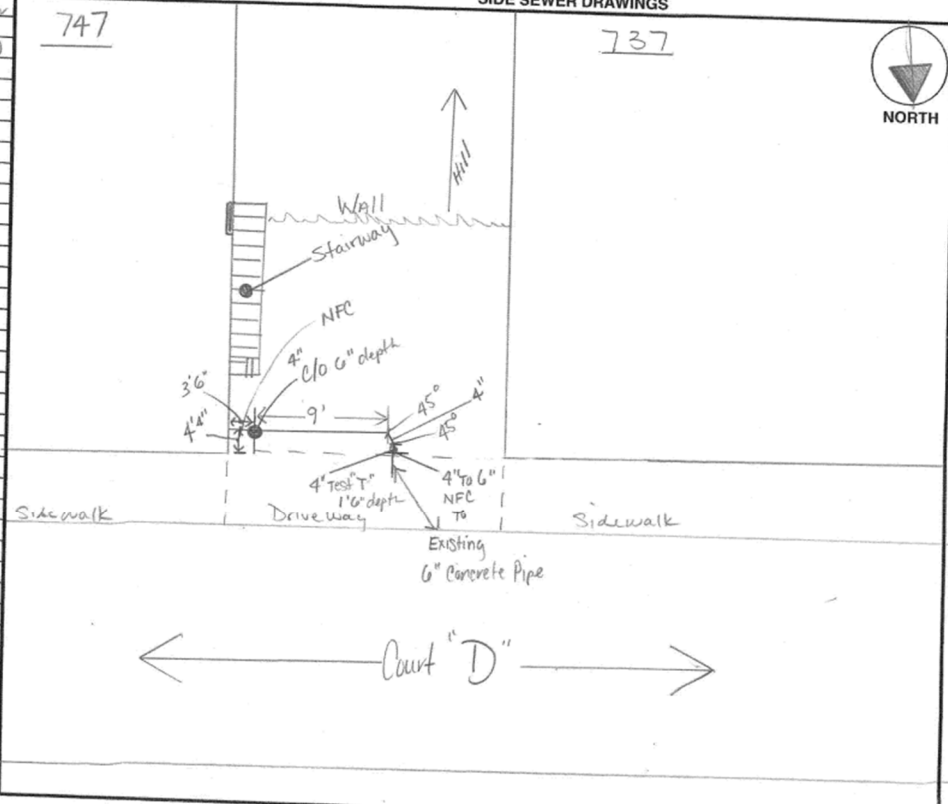
Click on each link individually to view all permits.

### 22 Inspection Cards

Filenames:  
[000165F2.pdf](#) [000165F3.pdf](#) [000165F4.pdf](#)  
[000165FC.pdf](#) [000165FD.pdf](#) [000165FE.pdf](#)  
[00016606.pdf](#) [SS581946-023.pdf](#)

More recent side sewer inspections may have an "SS" at the start of the link.

**Step 4** – The side sewer inspection may be 1 or 2 pages. You may need to go to the 2<sup>nd</sup> page to see the side sewer sketch.

<b>SANITATION RECORD</b>	BUILDING ADDRESS: 747 Market St.		DATE ISSUED: 7-31-13
	SAP NUMBER: 40000 205627		
<b>CITY OF TACOMA - Construction Division</b>			
<b>SIDE SEWER DRAWINGS</b>			
CONTRACTOR: All degree Sewer	747	737	 NORTH
INSPECTED BY: S. Taylor (JR)			
DATE INSPECTED: 8-2-2013			
COMMENTS:			
Pass / Fail / NA <input checked="" type="checkbox"/> Pass <input type="checkbox"/> Fail <input type="checkbox"/> NA Water/Air Test <small>Not applicable - See record for test results</small>			
Yes / No <input type="checkbox"/> Yes <input checked="" type="checkbox"/> No Compaction Test <small>None to Compact Area (Preparation Day Right of Way) (Check back at end of work.)</small>			
<b>LEGEND:</b> C/O = Clean-out NFC = Neoprene Flex Coupler (Fernco) CI = Cast Iron CIPP = Cured In Place Pipe CTP = Clay Tile Pipe HDPE = Hi-Density Polyethylene ( ) NEW <input checked="" type="checkbox"/> REPAIR ( ) OTHER			

To print the page, click on the print icon.